


MULHOLLAND DRIVE

BEVERLY DRIVE

# CONSTRUCTION STAKING PLAN


LOT 2, TRACT NO. 13374, MB 330-10-11, CITY OF LOS ANGELES  
BEVERLY DRIVE, LOS ANGELES

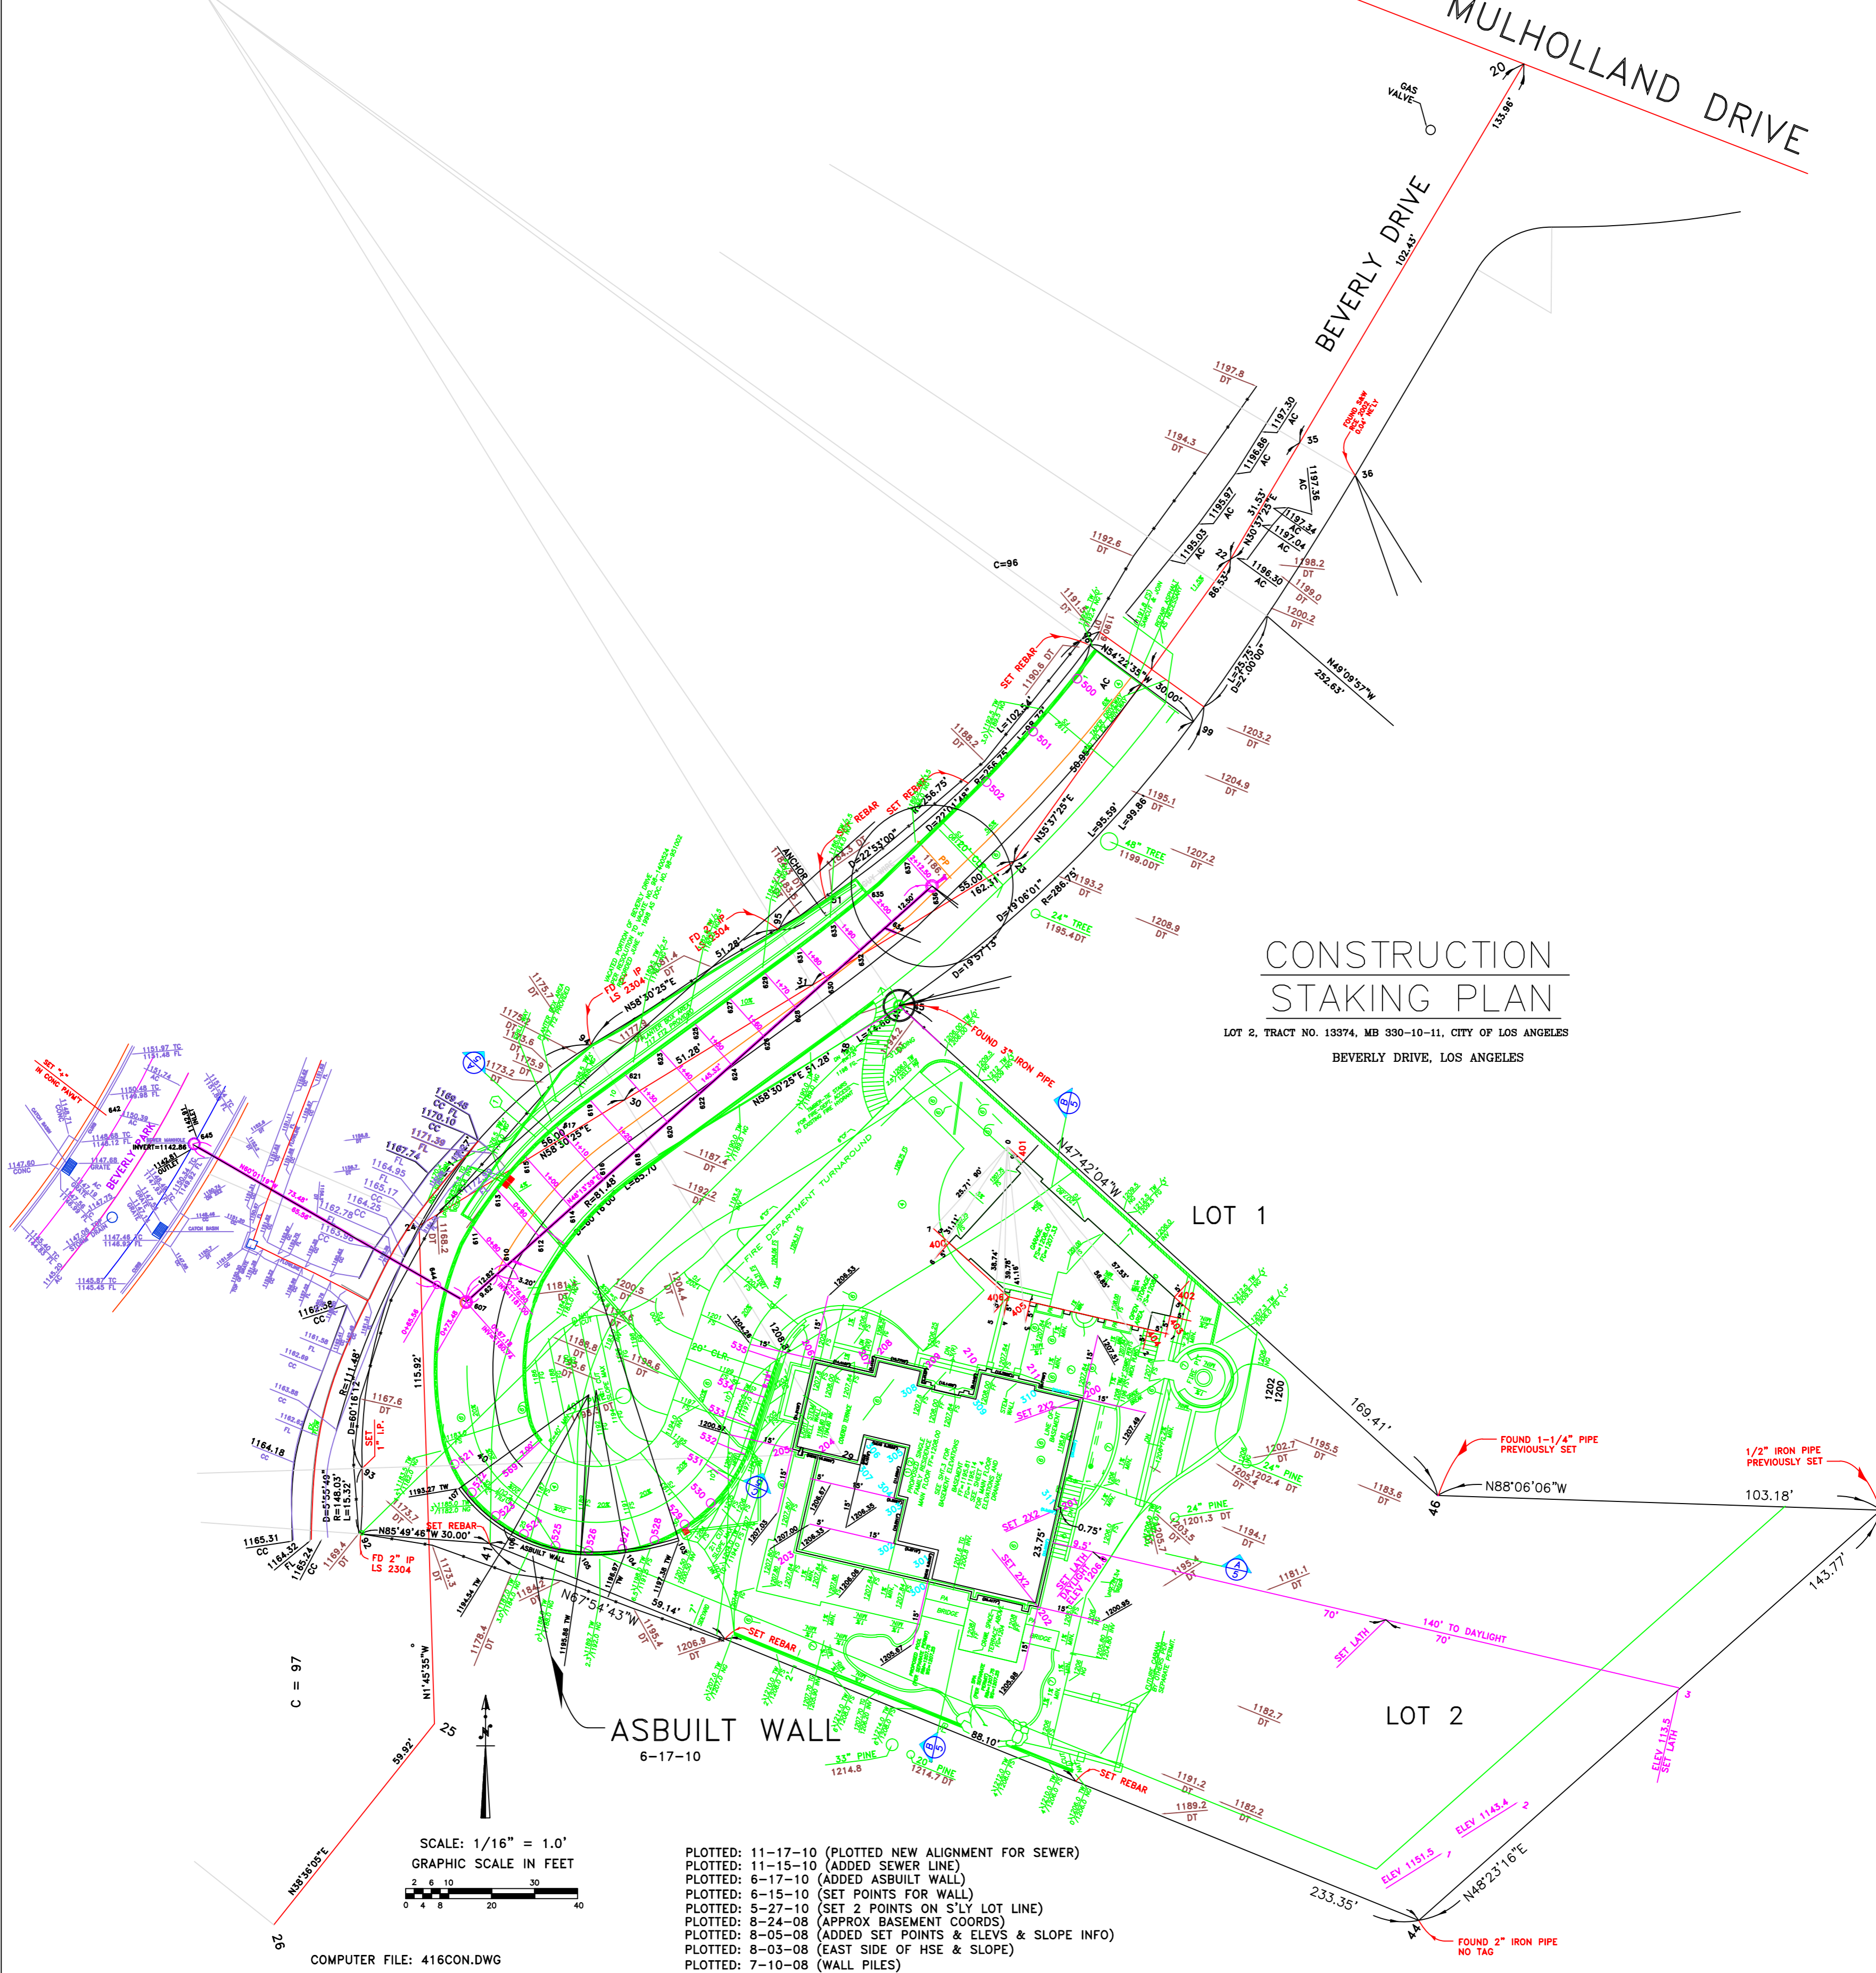

LOT 1

LOT 2

ASBUILT WALL  
6-17-10

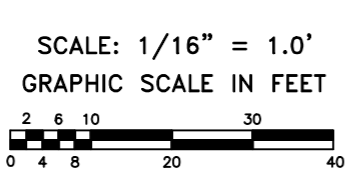

- PLOTTED: 11-17-10 (PLOTTED NEW ALIGNMENT FOR SEWER)
- PLOTTED: 11-15-10 (ADDED SEWER LINE)
- PLOTTED: 6-17-10 (ADDED ASBUILT WALL)
- PLOTTED: 6-15-10 (SET POINTS FOR WALL)
- PLOTTED: 5-27-10 (SET 2 POINTS ON S'LY LOT LINE)
- PLOTTED: 8-24-08 (APPROX BASEMENT COORDS)
- PLOTTED: 8-05-08 (ADDED SET POINTS & ELEVS & SLOPE INFO)
- PLOTTED: 8-03-08 (EAST SIDE OF HSE & SLOPE)
- PLOTTED: 7-10-08 (WALL PILES)

COMPUTER FILE: 416CON.DWG